M. FENCING TO BE PROVIDED TO EXTERIOR UTILITY ELECTRICAL EQUIPMENT. COORDINATE ALL SERVICE REQUIREMENTS WITH UTILITY PRIOR TO BID. DUCTBANKS, RACEWAYS, TERMINATIONS, AND FEEDERS FROM THE METER TO THE SERVICE ENTRANCE SHALL BE BY CONTRACTOR. DUCTBANKS AND RACEWAYS ON THE PRIMARY SIDE OF THE METER SHALL BE BY CONTRACTOR. ALL GEAR THAT INTERFACES WITH THE UTILITY MUST BE INSTALLED OUTSIDE OF THE SECURITY FENCE IN A MANNER CONSISTENT WITH UTILITY'S STANDARDS. COORDINATE ALL TERMINATIONS WITH UTILITY. COORDINATE UPSTREAM PROTECTIVE DEVICES AND ANY REQUIRED DOWNSTREAM PROTECTIVE DEVICES WITH UTILITY.

2.0

N. PROVIDE CHARGEPOINT CP-6000 CHARGING STATIONS OR SIMILAR WITH DUAL PORT.

O. PROVIDE ALL PARTS, PIECES, AND APPURTENANCES REQUIRED FOR A FULLY FUNCTIONING EV CHARGING SYSTEM.

GENERAL NOTES:

A. FOR ELECTRICAL SYMBOLS, ABBREVIATIONS AND NOTES REFER TO DRAWING E-002.
B. FOR ELECTRICAL POWER ONE LINE DIAGRAMS, REFER TO THE E-500 DRAWING SERIES.
C. CONTRACTOR SHALL NOT CONSTRUCT OR FABRICATE DIRECTLY FROM THIS DRAWING. CONTRACTOR SHALL NOT SCALE FROM THESE DRA THE SERVICES SPECIFICATIONS AND DR ANT CONTRACT DOCUMENTS. ALL APPLICABLE LOCAL C

COPC APPROVED: 11/12/2025
APP REQ #: 6381

D. CONTRACTOR SHALL PRI INGS (AS BUILT DRAWINGS) FOR THE PURPOSES OF I
E. EQUIPMENT AND PLANT I LECTED EQUIPMENT SHALL MEET THE GIVEN CONSTI
F. ALL SERVICE PENETRATI TOPPED TO ACHIEVE A RATING EQUIVALENT TO THE COMPARTMENT AND SHALL BE DESIGNED TO ACCOMMODATE THERMAL MOVEMENT.
G. COORDINATE THE EXACT LOCATION AND POWER CONNECTION TO EQUIPMENT WITH THEIR RESPECTIVE TRADES. CONFIRM EQUIPMENT POWER REQUIREMENTS WITH APPROVED SHOP DRAWINGS.
H. PROVIDE CABLE TRAY DIVIDER TO SEGREGATE POWER & CONTROL WIRING.
I. NOT USED.
J. PROVIDE (2) 2" CONDUITS FROM UTILITY SWITCHGEAR & METERING ENCLOSURE TO BUILDING FOR OWNER MONITORING OF UTILITY METER.
K. FOR CONDUIT SET LAYOUT PLAN REFER TO DRAWING E-003.

2.0

L. PROVIDE CHARGEPOINT CP-6000 CHARGING STATIONS OR SIMILAR WITH SINGLE PORT FOR ACCESSIBLE EV CHARGING.

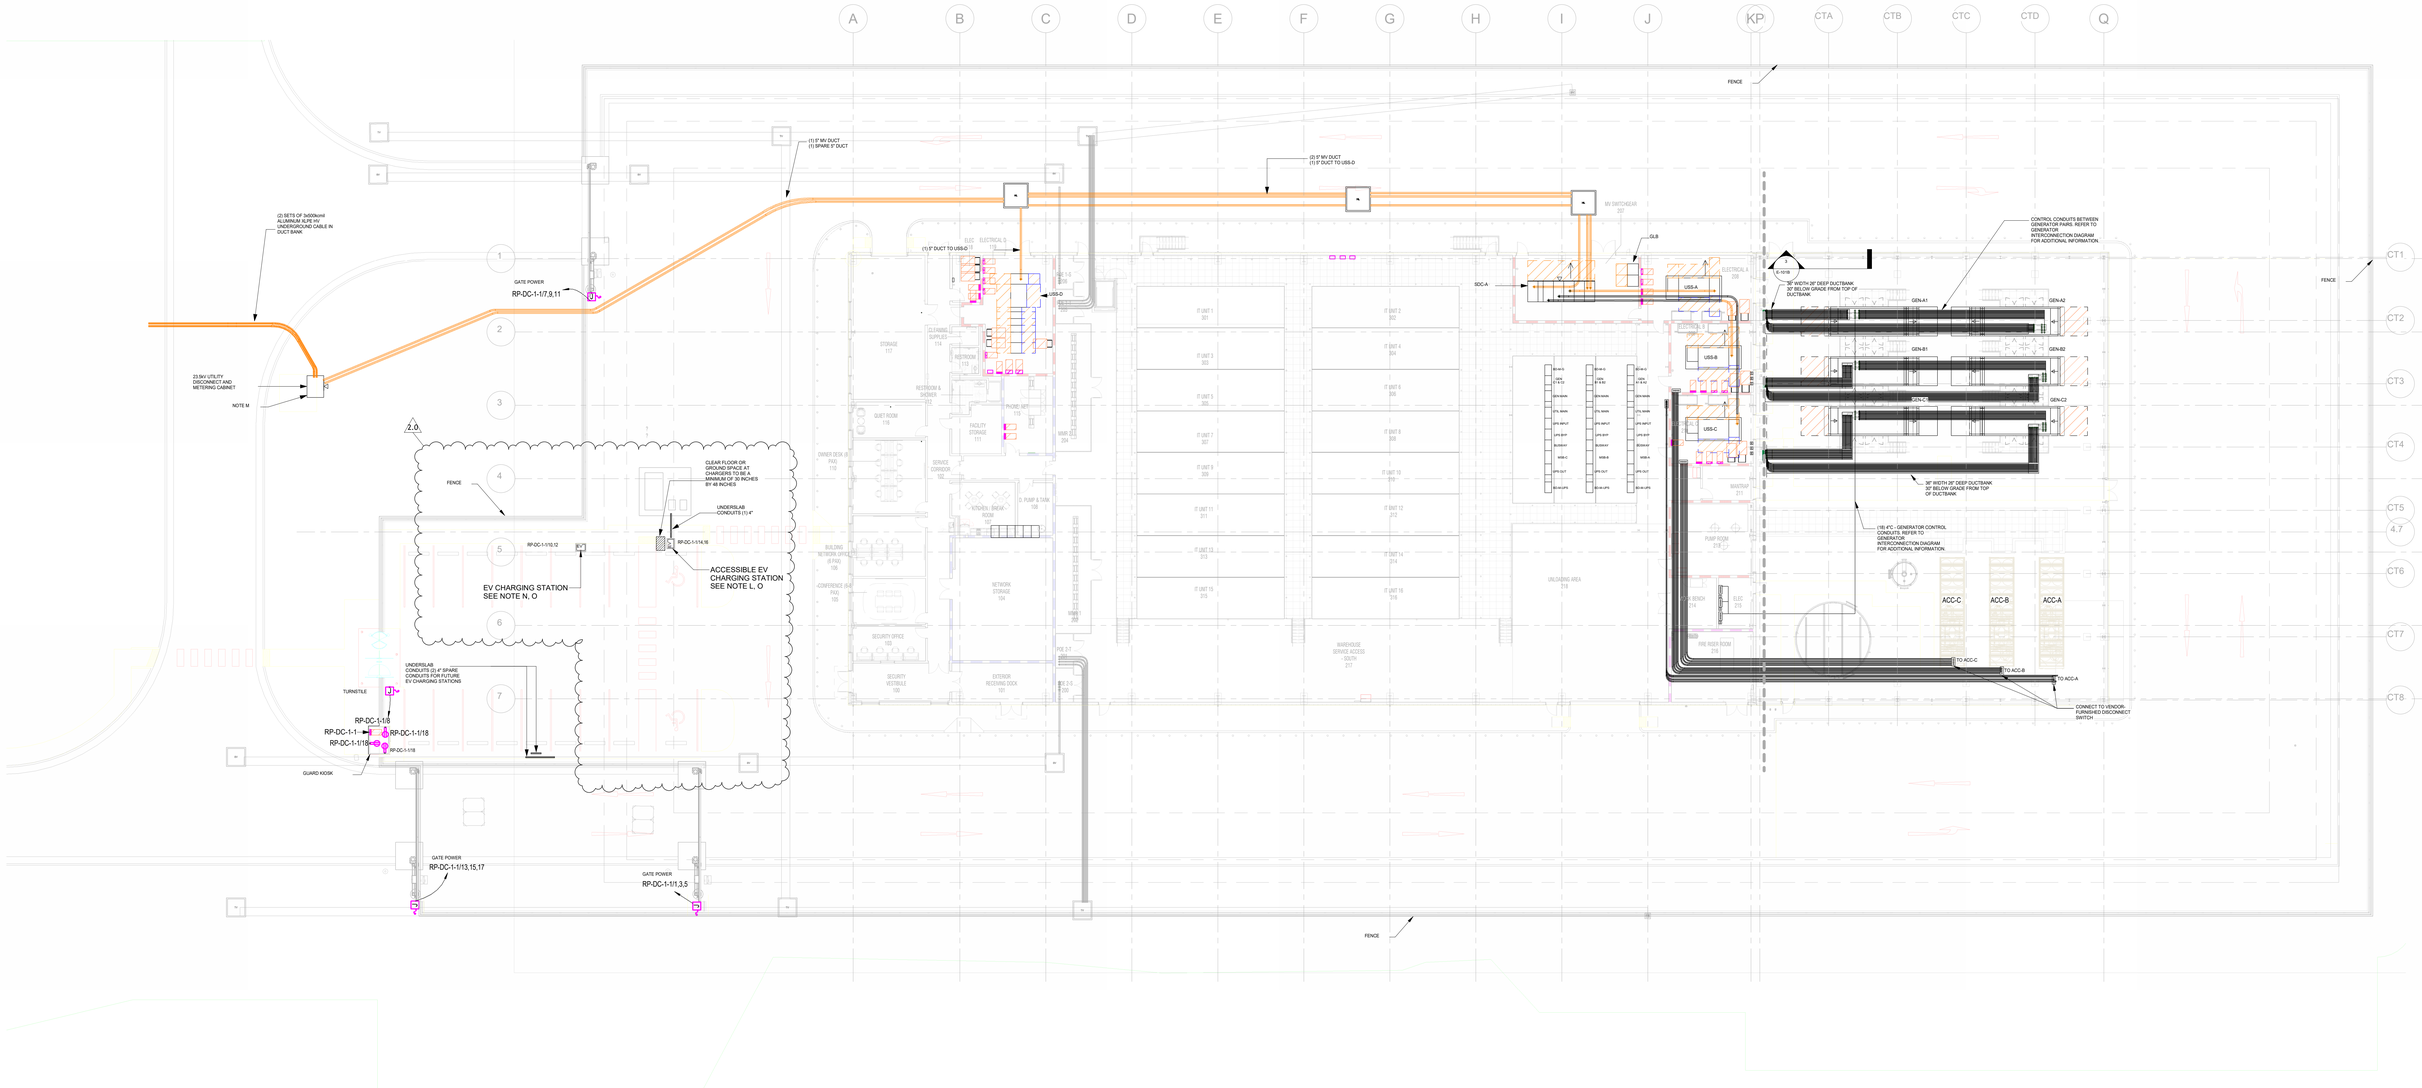

1 SITE CONTAINMENT PLAN OVERALL
SCALE 1/16" = 1'-0"

9/15/2025 2:54:37 PM Autodesk Docs://Gumbo/GUMBO-ELEC-FA.rvt

Jacobs
777 Main St
Fort Worth, TX 76102
P 817.735.6000
F 817.735.6148
www.jacobs.com

DAVID ISAAC WATTS LICENSE No 95762 STATE OF FLORIDA PROFESSIONAL ENGINEER
09/15/2025

CONFIDENTIAL

A | B

N

REVISIONS		
NO.	DATE	DESCRIPTION
1.0	2025-06-20	TECHNICAL SITE PLAN APPLICATION
2.0	2025-09-15	TECHNICAL SITE PLAN - 2ND SUBMISSION

Drawn By: SM
Approved By: DIW
Design Team: JACOBS

GUMBO

CONTAINMENT SITE PLAN OVERALL

Discipline: ELECTRICAL

Scale: 1/16" = 1'-0" Sheet Size: A0

Sheet Number: **E-050**

Current Rev: 2.0
Phase: VE ISSUE FOR CONSTRUCTION
Model Name: GUMBO-ELEC-FA
Native File Format: Revit V. 2024.2